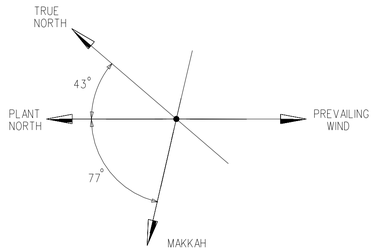


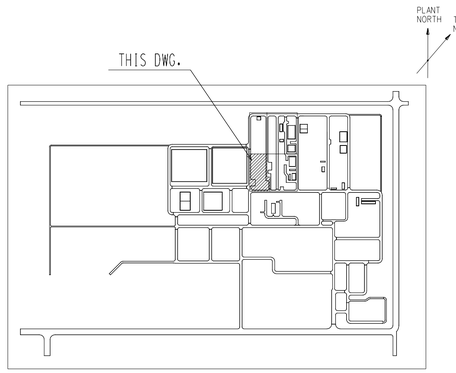


KEY PLAN

| EQUIPMENT NO. | DESCRIPTION |
|---|---|
| UNIT 32,33 | |
| D-3301 | SIDRUM |
| D-3308 | EB VAPORIZER CONDENSATE POT |
| E-3301 | EB VAPORIZER |
| E-3302 | RM/STEAM INTERCHANGER |
| E-3303 | EB/STEAM SUPERHEATER |
| E-3304 | SI WASTE HEAT EXCHANGER |
| E-3306 | MAIN CONDENSER |
| F-3301 | STEAM SUPERHEATER |
| R-3301 | FIRST STAGE DEHYDROGENATOR |
| R-3302 | SECOND STAGE DEHYDROGENATOR |
| AS-3303 | ANALYZER SHELTER - SM UNIT #3 |

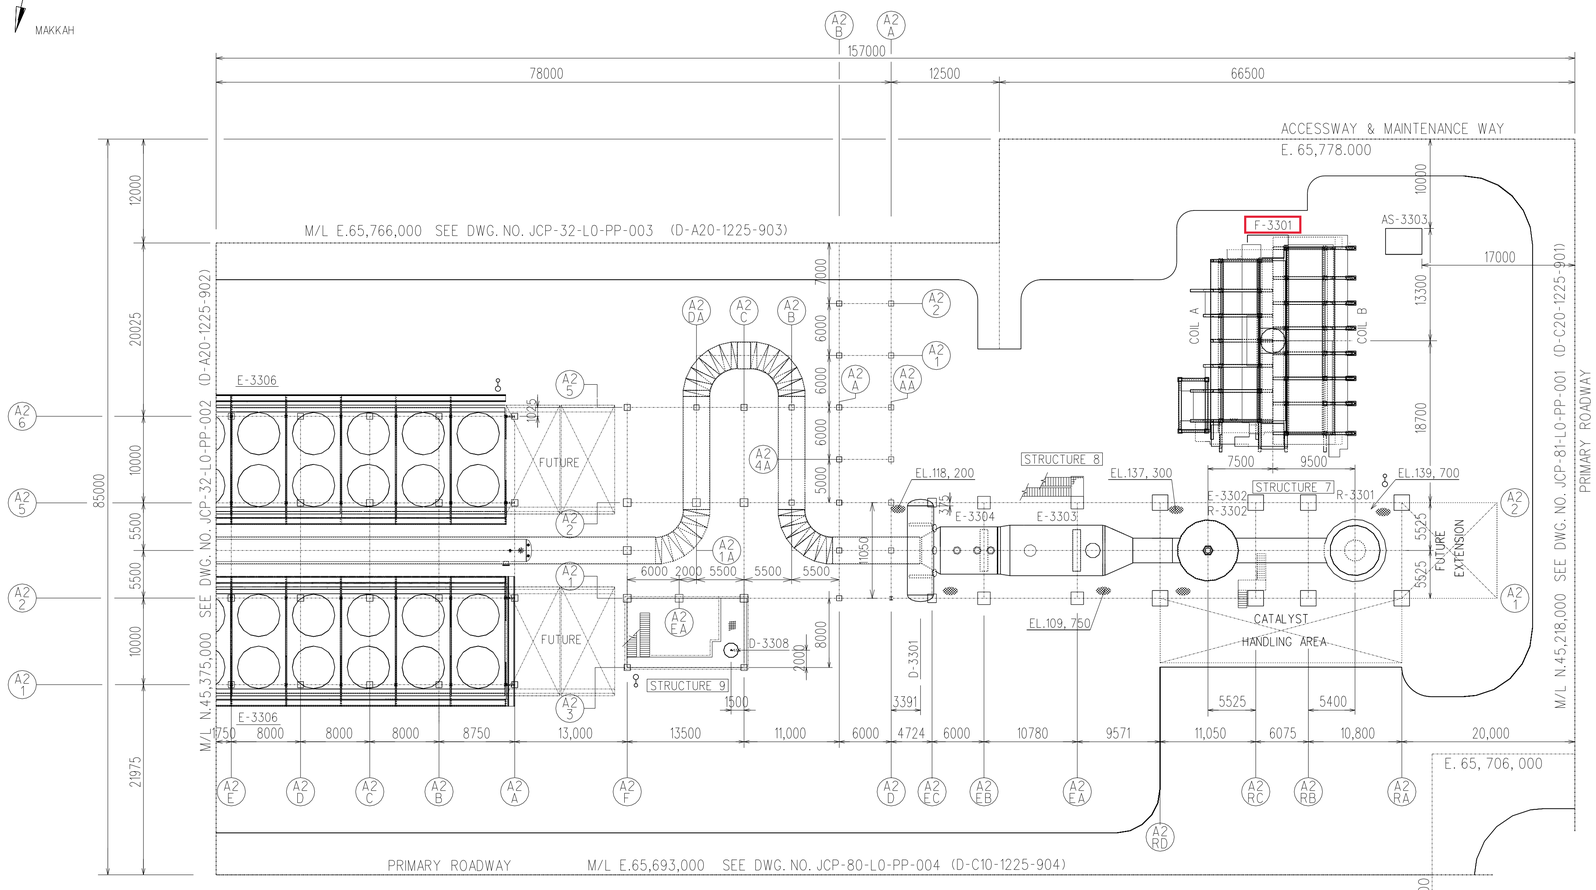


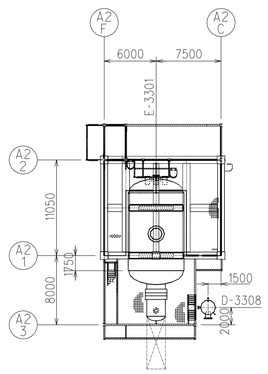

NOTES

1. GRADE ELEVATION ( HIGHT POINT PAVING ) SHOWN ON THIS DRAWING EL. 100,000
2. ALL COORDINATES ARE IN METERS.
3. ALL ELEVATIONS AND DIMENSIONS ARE IN MILLIMETERS.
4. LOCATE E-3354 ON THE STRUCTURE ABOVE OF D-3351.
5. 5M MIN. ACCESS CLEARANCE REQUIRED UNDER R-3302.
6. TOP TANGENT LINE OF D-3308 IS TO BE ELEVATED NO HIGHER THAN THE BOTTOM OF E-3301.
7. ⚷: SAFETY SHOWER/EYE WASH STATION.

| REV. | DATE | DESCRIPTION | DRAWN | CHKD. | APPVD. | REFERENCE DRAWING |
|---|---|---|---|---|---|---|
| 00 | 01 Dec 2007 | As Built | R.Sanonte | Y.Yamamoto | H.Kaji | |

CONFIDENTIAL INFORMATION - REPRODUCTION AND USE PROHIBITED EXCEPT IN ACCORDANCE WITH JUBAIL CHEVRON PHILLIPS COMPANY'S WRITTEN PERMISSION.

EPC CONTRACTOR: JGC

MANAGING CONTRACTOR: PARSONS E&C

JCP

| | INITIAL | DATE |
|---|---|---|
| DRAWN | | |
| CHECKED | | |
| CONTRACTOR. APPROVAL | | |
| JCP APPROVAL | | |
| SCP REVISION | | |

TITLE

UNIT PLOT PLAN

UNIT 32,33

| SCALE | PROJECT NO. | CONTRACT NO./ WORK ORDER NO. | DWG. NO. | REV |
|---|---|---|---|---|
| 1:250 | | | JCP-32-L0-PP-001 | 00 |

FILE NAME : D-A20-1225-901_C03_0001.dgn

0-3515-2

D-A20-1225-901 < 00 >

A0 1189x841